


REF. -	NAME.	REV A	DWG No FLO1393
J/No. 1393	MATERIAL. -		
QTY EACH. -	DESCRIPTION. FLOW DIAGRAM AS BUILT		DRAWN BY VEE
ISSUE DATE. 16 12 2003	NOTES. -		CHECKED -
			SCALE NTS



ALL DIMENSIONS IN MILLIMETRES

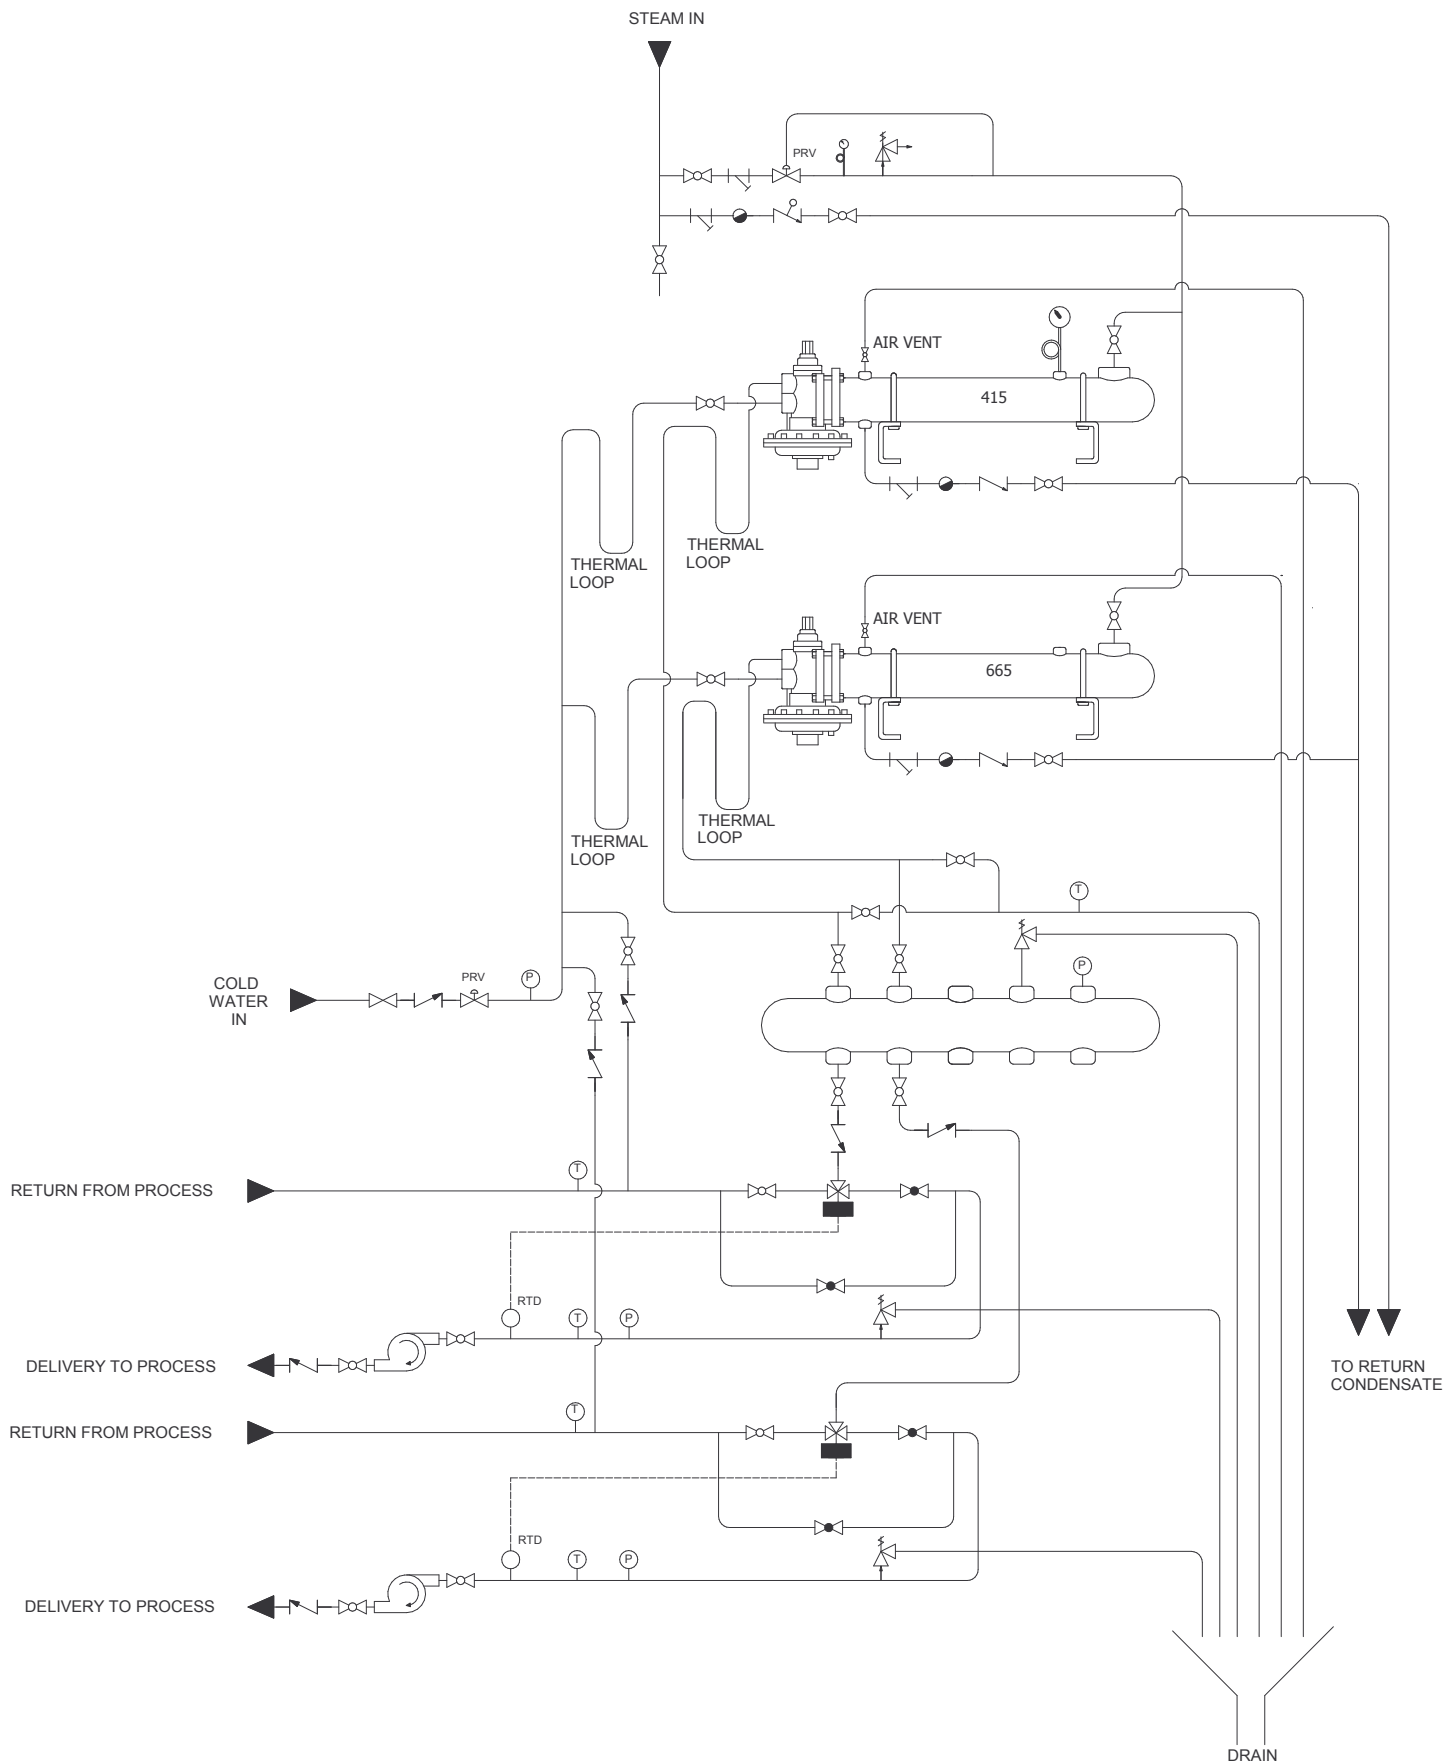